


TAFT CENTER
LOT 1 BLOCK 1
400 BLOCK E TAFT
SAPULPA OK 74010

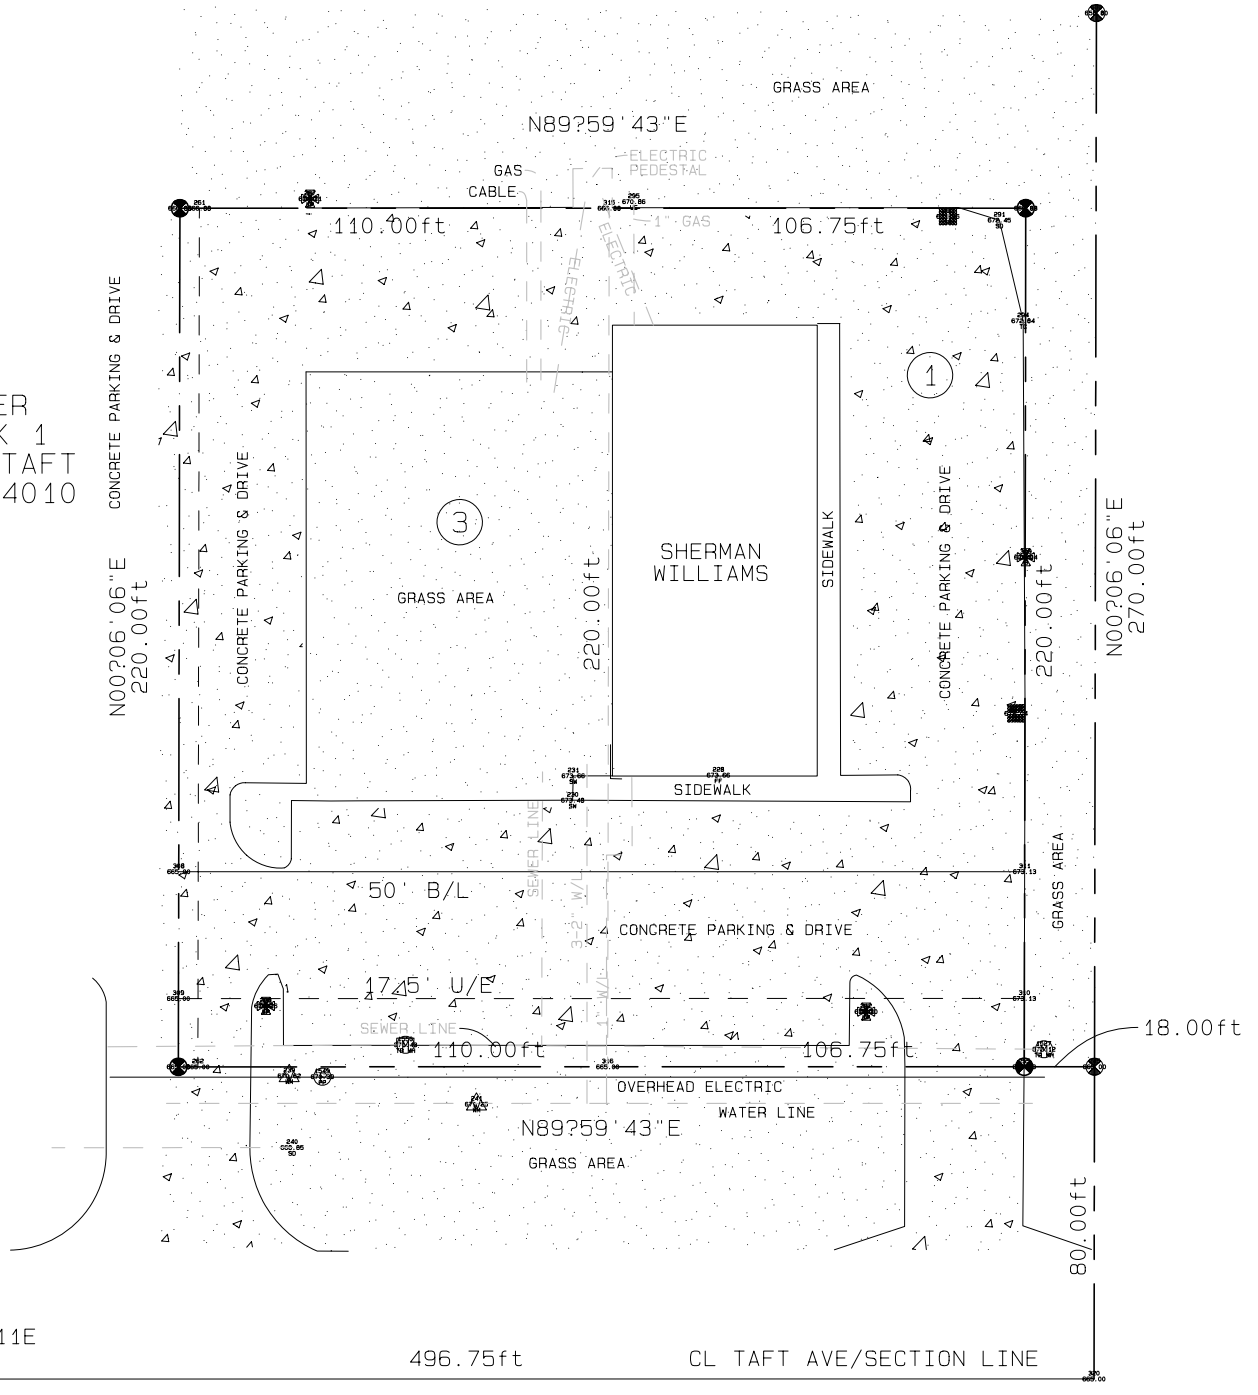

SW/C SE/4
SEC 35-T18N-R11E
BRASS CAP FND

496.75ft

CL TAFT AVE/SECTION LINE